







DRAWN BY JEFF BROWN	DATE	EOS Space Systems 111 Canberra Ave Griffith, ACT AUSTRALIA	
CHECKED KB	DATE 25 Oct 2006	Lick Control System - Wiring Diagram THUD SENSOR UNIT - LEVEL 1	
APPROVED 		DRAWING NUMBER WD-501306-01 - As Built	SIZE A1
SCALE NTS	SHEET 1 OF 1		



DRAWN BY JEFF BROWN	DATE	EOS Space Systems 111 Canberra Ave Griffith, ACT AUSTRALIA	
CHECKED KB	DATE 26 Oct 2008		
APPROVED 	DATE 26/10/08	Lick Control System - Wiring Diagram THUD SENSOR UNIT - LEVEL 3	DRAWING NUMBER WD-501307-01 - As Built
SCALE NTS	SHEET 1 OF 1	SIZE A1	

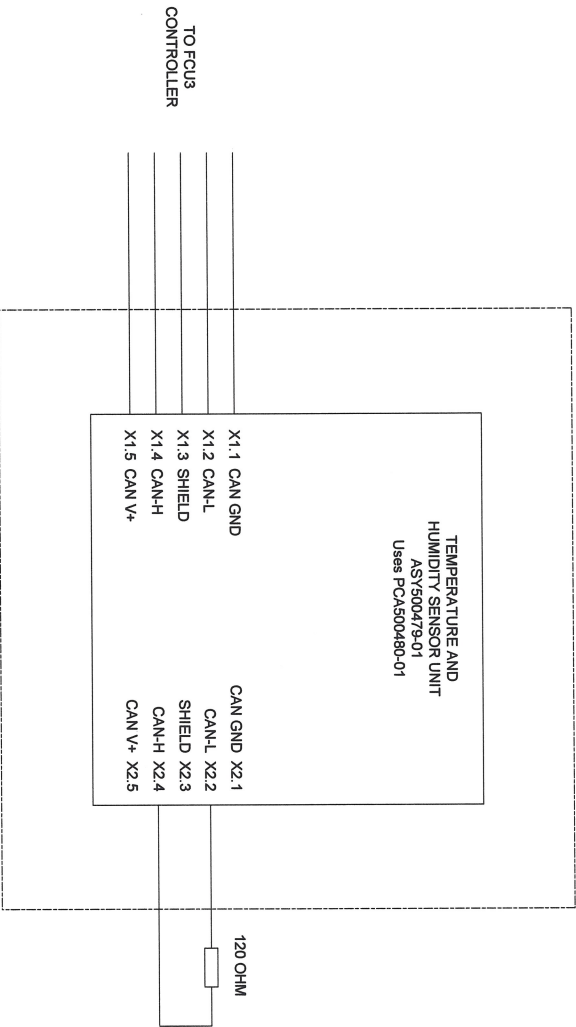

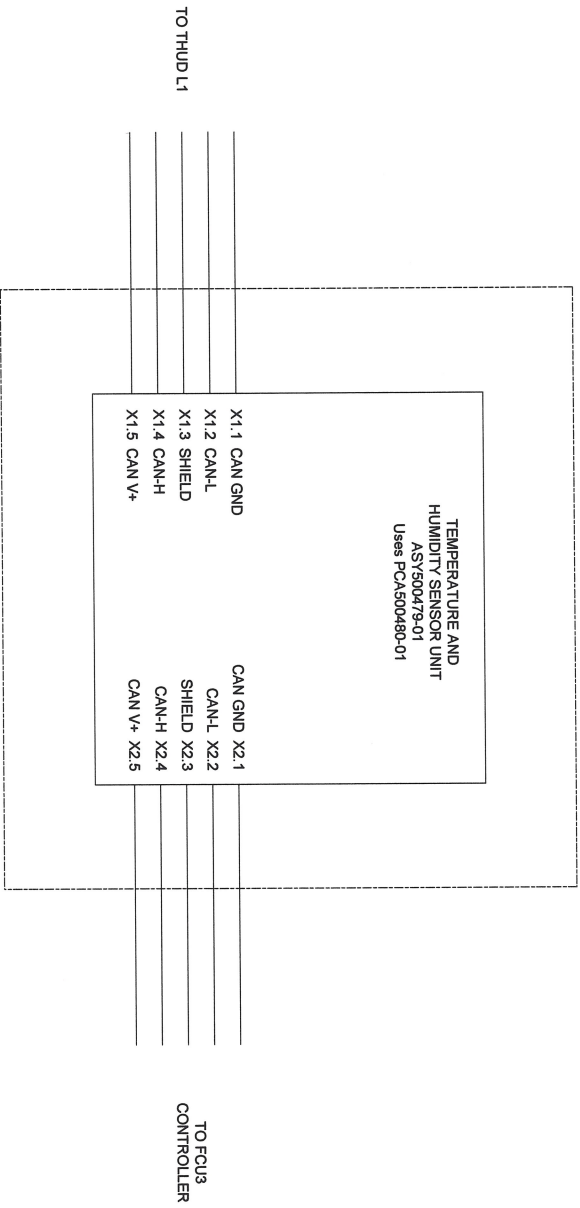DRAWN BY	DATE	EOS Space Systems	DRAWING NUMBER	SCALE	SIZE
JEFF BROWN		111 Canberra Ave Griffith, ACT AUSTRALIA	WD-501308-01 - As Built	NTS	A1
CHECKED	DATE	EOS SPACE SYSTEMS	Lick Control System - Wiring Diagram	SHEET	1 OF 1
KB	25 Oct 2006				
APPROVED	DATE				
<i>[Signature]</i>	26/10/06				